



SUITE DATA:

OFFICE AREA	978 SF
WAREHOUSE AREA	913 SF
COMMON AREA	341 SF
TOTAL SUITE AREA	2232 SF

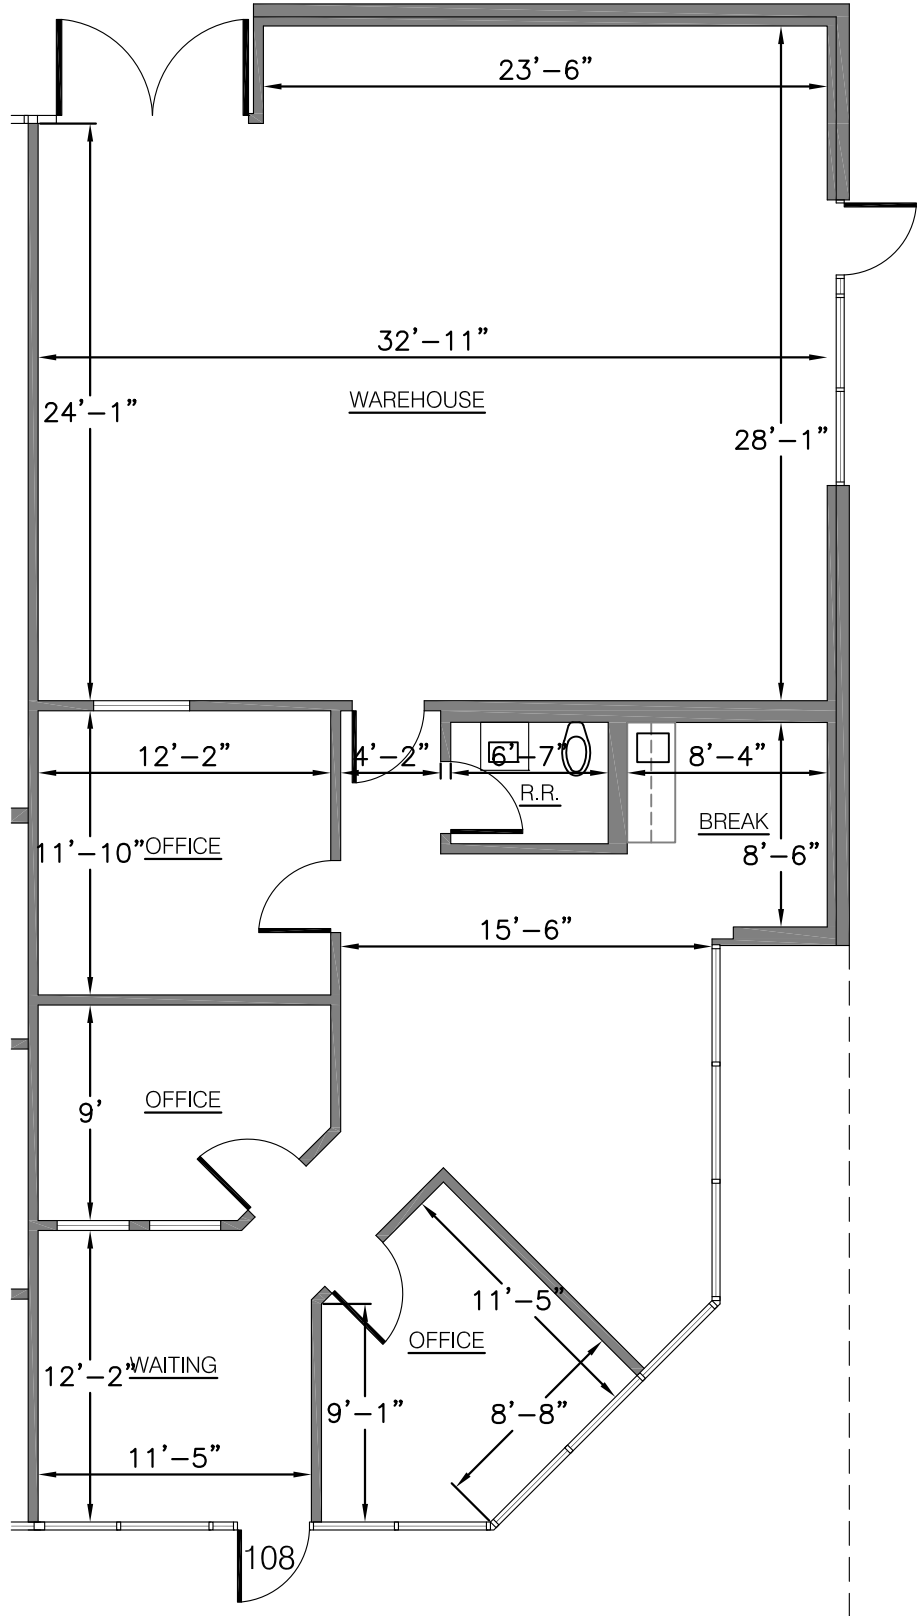

BUILDING KEY PLAN

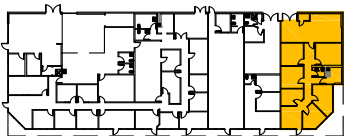

MeasuredPoint

3D Laser Scanning • Survey • As-Built • BIM/VDC

60 E. Rio Salado Pkwy, Ste 900 Tempe, AZ 85281

www.measuredpoint.com

(480)369-1236 main info@measuredpoint.com

FILE LOCATION:

DATE: 5/31/19

SCALE: N.T.S.

SHEET 4 OF 6

PRINTED BY: VIGIL

DRAWING NUMBER

5032-108

TITLE:

BKM MANAGEMENT
5032 S ASH
BLDG 2 STE 108
FLOOR PLAN