


Koill Cotton Center
4050 East Cotton Center Boulevard
suite 77 - 3,163 SF

ERROR UNKNOWN DOCUMENT PROPERTY NAME.

FORM - 1203

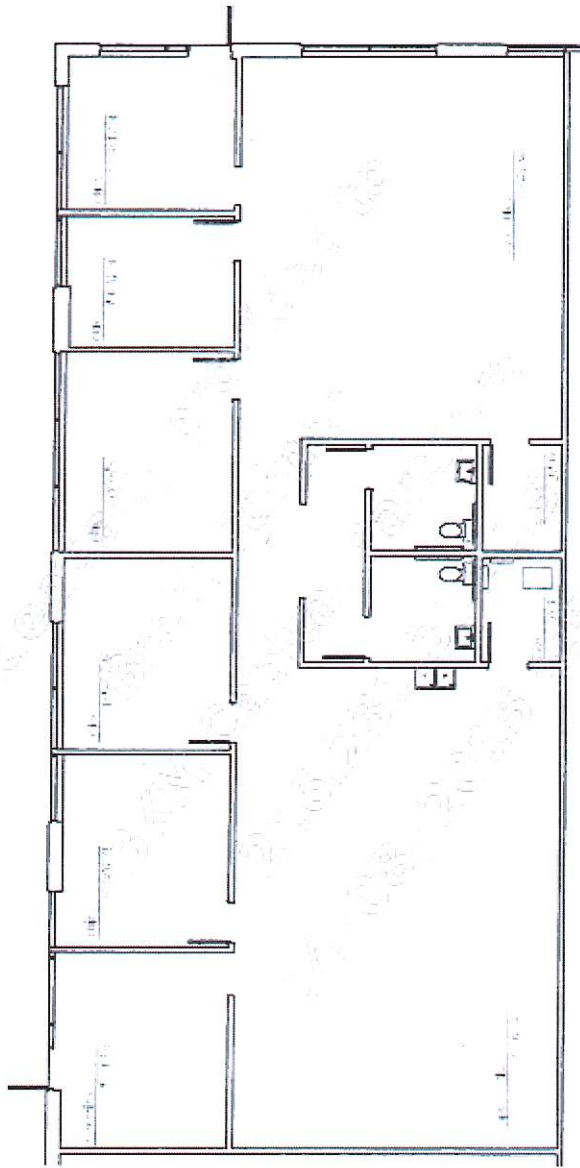

as-built

scale: n/a
12 February 2007
© Precision Measurements
10000 1/2 N. 10th St., Suite 100
Edmonton, AB T6A 1K6

precision **MEASUREMENTS**

as built - space plans
architectural design
602.790.6412

